



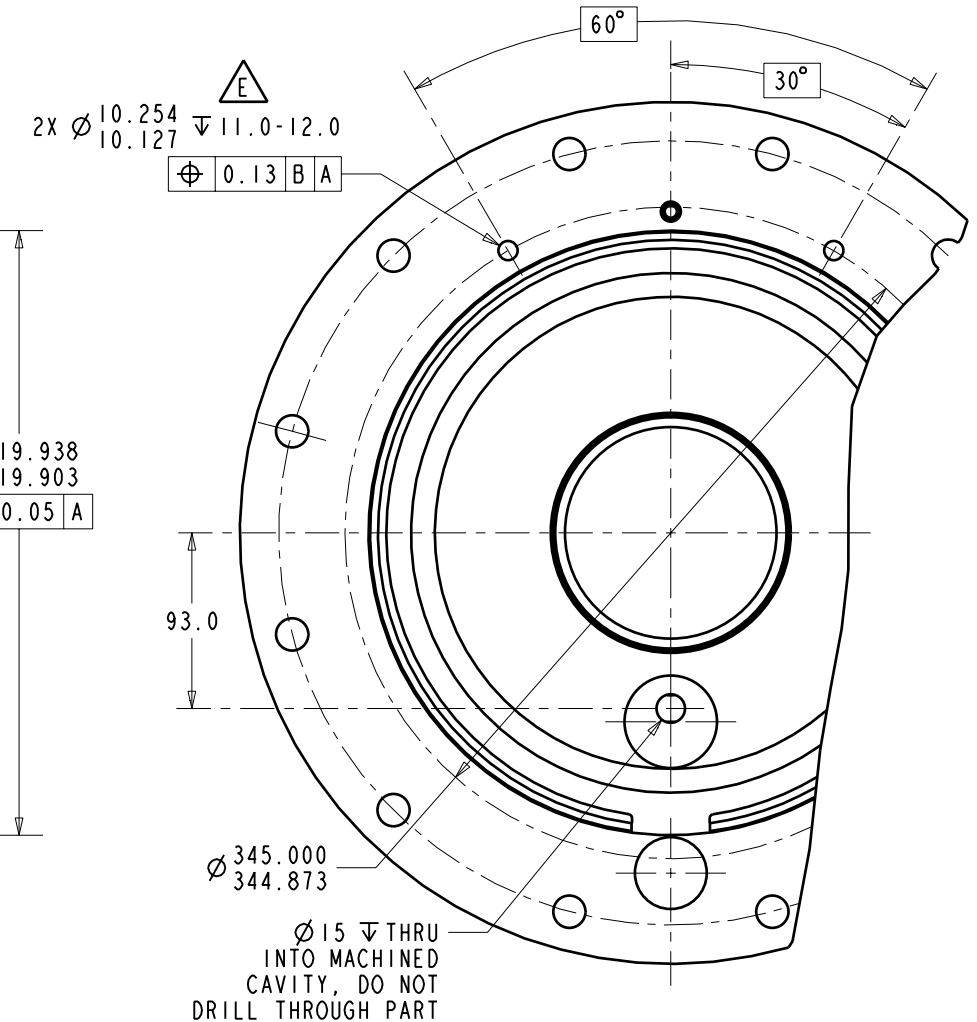

SECTION A-A

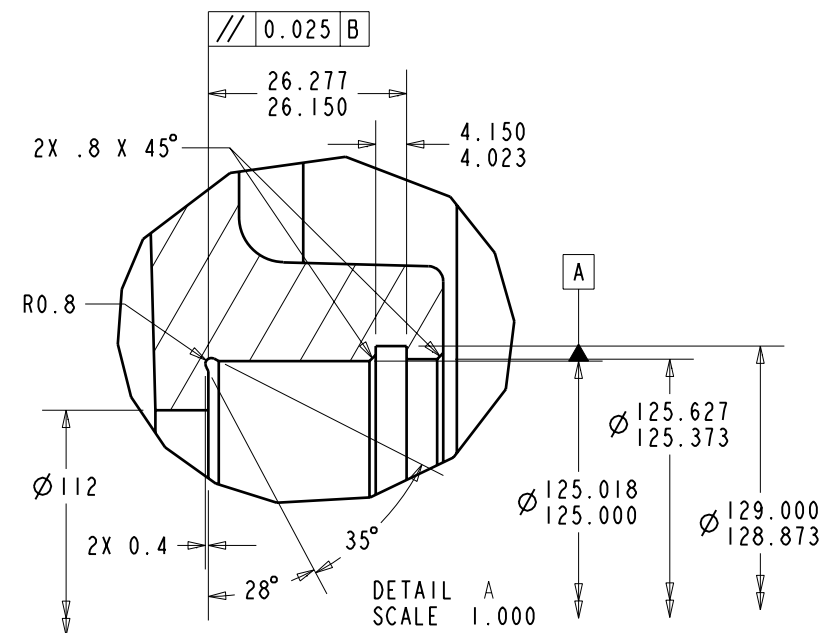

REV	CHANGED FROM	BY	DATE	APVD	REPORT ERRORS & CHANGES REMOVE ALL SHARP EDGES DIMENSIONS ARE IN MM UNSPECIFIED TOLERANCES: DECIMALS: FINISH: ANGLES:	Powertrain Engineers Inc W293 N3819 Round Hill Circle Pewaukee Wi, 53072					
A	RELEASED	PEI	11/02/07		X, ±1.0 Ra 3.2 µm < ±0.5 .X ±0.5 .XX ±0.25	COVER, END (MACHINING)					
B	RELEASED FOR DESIGN REVIEW	PEI	11/30/07								
C	REVISED PER MARK-UPS FROM DESIGN REVIEW	PEI	12/19/07								
D	ADDED HOLES FOR LOCKING SPACER 251329	PEI	10/23/08								
E	ADDED DRILL DEPTH FOR LOCKING HOLES	PEI	12/08/08		NOT TO BE MAKE OTHER	COPYRIGHT © REPRODUCED OR USED TO DRAWINGS OR MACHINERY.		SIZE B	FIRST USED ON	DWG NO. 251339	REV E
					DRAWN CHECKED	PEI	DATE 11/02/07	SCALE: 0.250	WEIGHT: 41.4 Kgs	SHEET 1 OF 1	